

- NOTES:
- ALL DIMENSIONS ARE IN MILLIMETERS
 - MATERIAL: PLAIN CARBON STEEL

THIRD ANGLE PROJECTION




PROPRIETARY AND CONFIDENTIAL

THE INFORMATION CONTAINED IN THIS DRAWING IS THE SOLE PROPERTY OF SOLIDWORKS. ANY REPRODUCTION IN PART OR AS A WHOLE WITHOUT THE WRITTEN PERMISSION OF SOLIDWORKS IS PROHIBITED.




| | | | |
|-----------|--------------------|--------|----------|
| DRAWN BY: | JMD | DATE | 01-01-24 |
| MATERIAL: | PLAIN CARBON STEEL | SCALE: | 1:1 |

MODEL MANIA® 2024
Phase 1


PHASE 2 ENGINEERING CHANGE ORDER: INCREASE UPPER BOSS SIZE TO BE TANGENT TO BLUE FACE, REMOVE MATERIAL AS SHOWN AND ADD 5.0° DRAFT

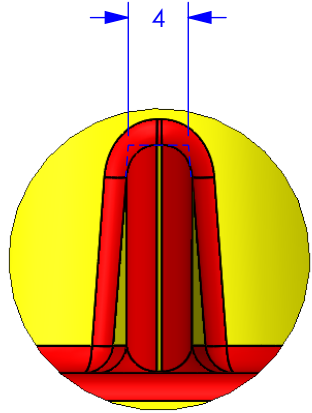



DETAIL C
SCALE 2 : 1

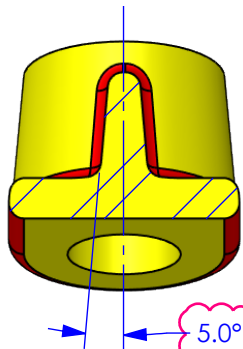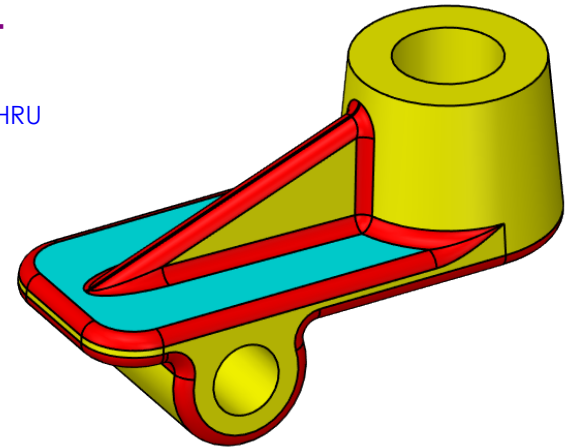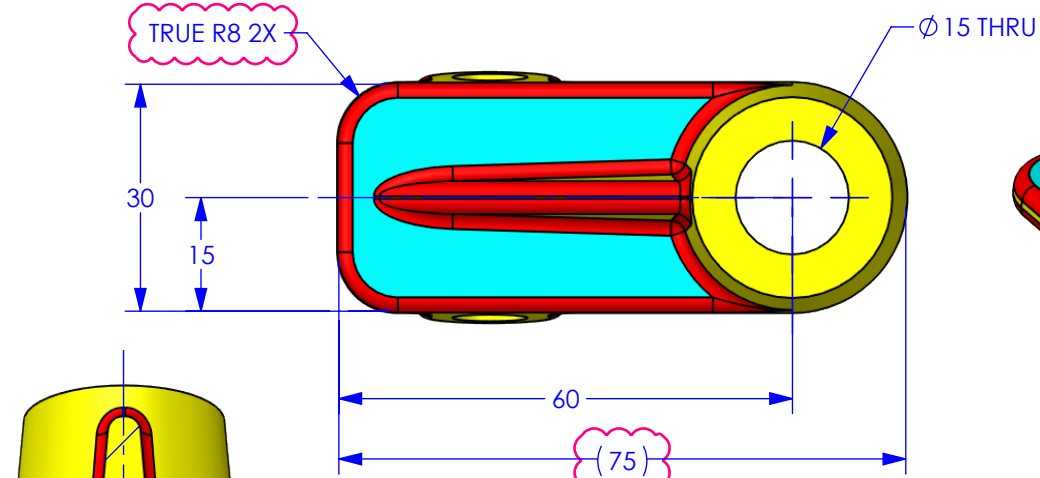

SECTION E-E
(SHOWN NORMAL
TO RIB)

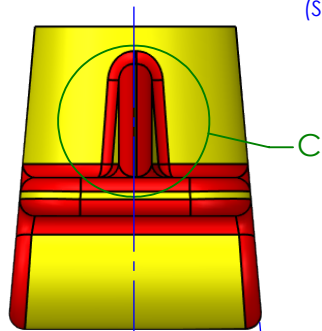


5.0° TYP
DRAFT

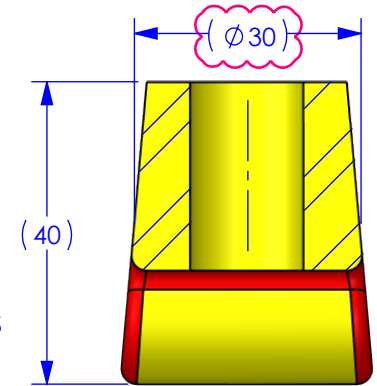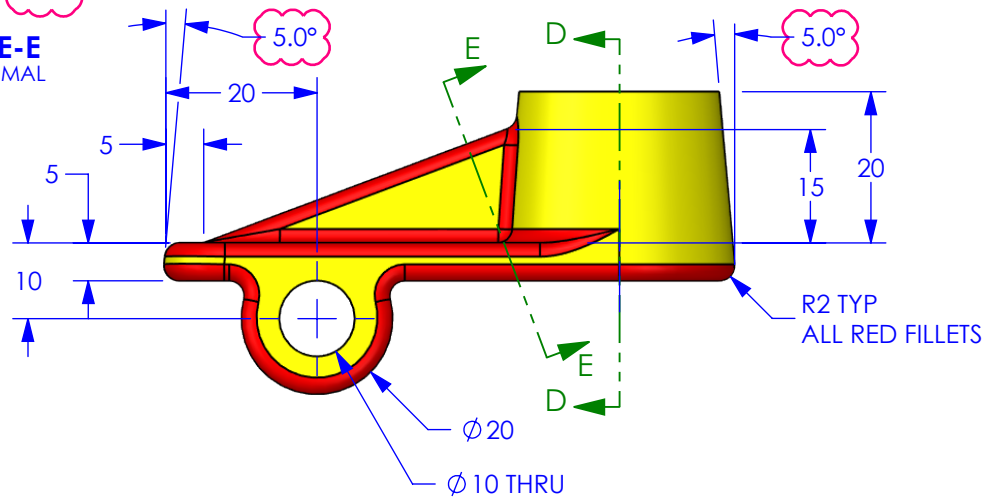

SECTION D-D

NOTES:

1. ALL DIMENSIONS ARE IN MILLIMETERS
2. MATERIAL: PLAIN CARBON STEEL
3. MAKE CHANGES AS INDICATED IN RED REVISION CLOUDS.
4. ALL OTHER DIMENSIONS REMAIN THE SAME AS IN PHASE 1.

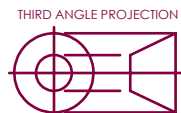

PROPRIETARY AND CONFIDENTIAL

THE INFORMATION CONTAINED IN THIS DRAWING IS THE SOLE PROPERTY OF SOLIDWORKS. ANY REPRODUCTION IN PART OR AS A WHOLE WITHOUT THE WRITTEN PERMISSION OF SOLIDWORKS IS PROHIBITED.

THE INFORMATION CONTAINED IN THIS DRAWING IS THE SOLE PROPERTY
OF SOLIDWORKS. ANY REPRODUCTION IN PART OR AS A WHOLE WITHOUT
THE WRITTEN PERMISSION OF SOLIDWORKS IS PROHIBITED.

| | | |
|-----------|--------------------|----------|
| | NAME | DATE |
| DRAWN BY: | JMD | 01-01-24 |
| MATERIAL: | Plain Carbon Steel | |

MODEL MANIA® 2024

Phase 2

SCALE: 1:1